MICROFILMED

PLAT AND RECORD

COUNTY BUILDING
CITY OF JANESVILLE

Of a Survey on Section 17 T 3 R 14 E. of the 4 P. M. in Johnstown Township

Rock County, Wisconsin, made January the 12, 15, 16 1867

I hereby certify that the following is a correct record of said survey as made by me.

(Signed) S. D. Locke
R.H.B. County Surveyor.

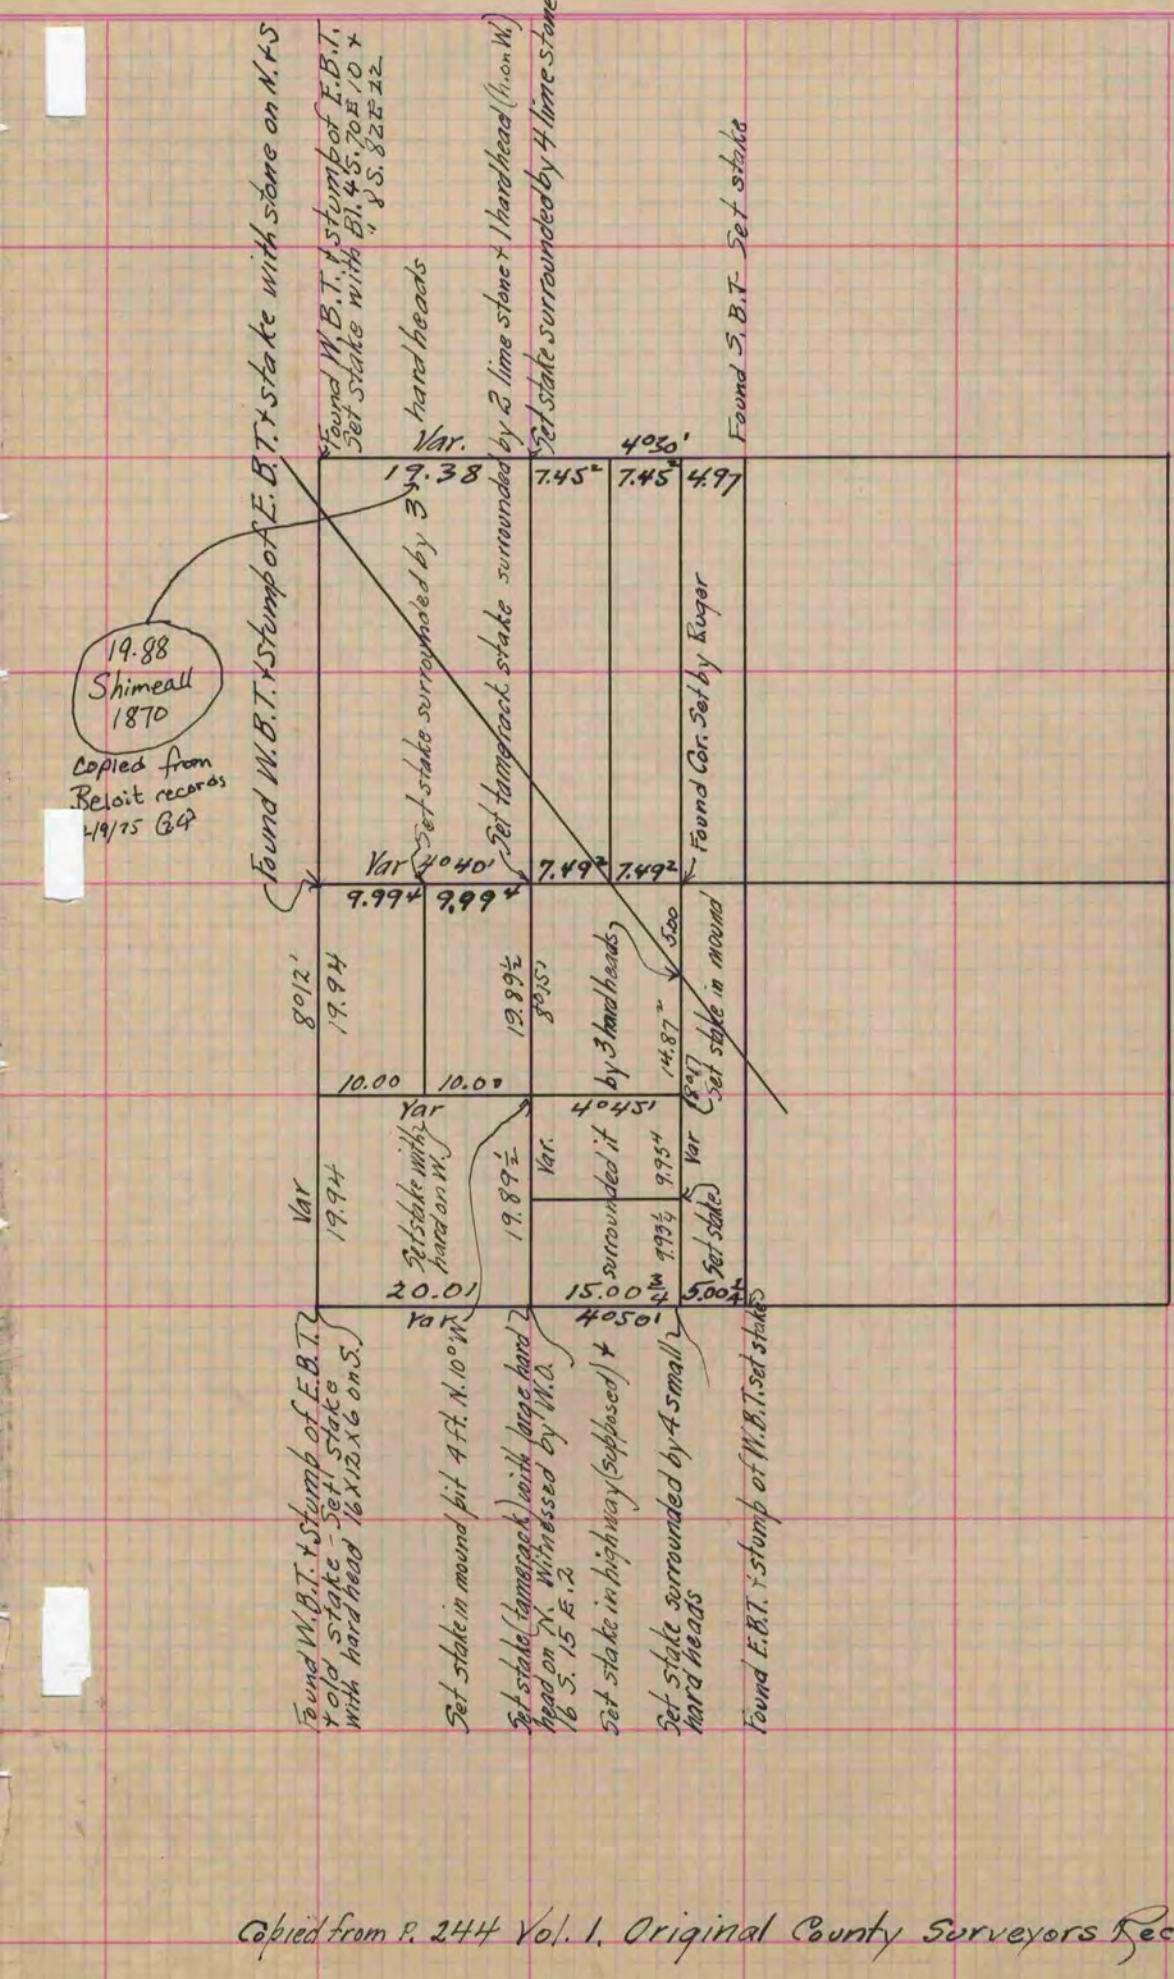

Copied from P. 244 Vol. 1. Original County Surveyors Record