300
V-7
MICROFILMED

PLAT AND RECORD

Of a Survey on Section 1 T 4 R 12 E. of the 4 P. M. in Fulton Township

Rock County, Wisconsin, made May the 5th, 6th & 7th 1880

COUNTY BUILDING
CITY OF JANESVILLE

I hereby certify that the following is a correct record of said survey as made by me.

(Signed) R. K. Kee Dept.
R.H.B. County Surveyor.

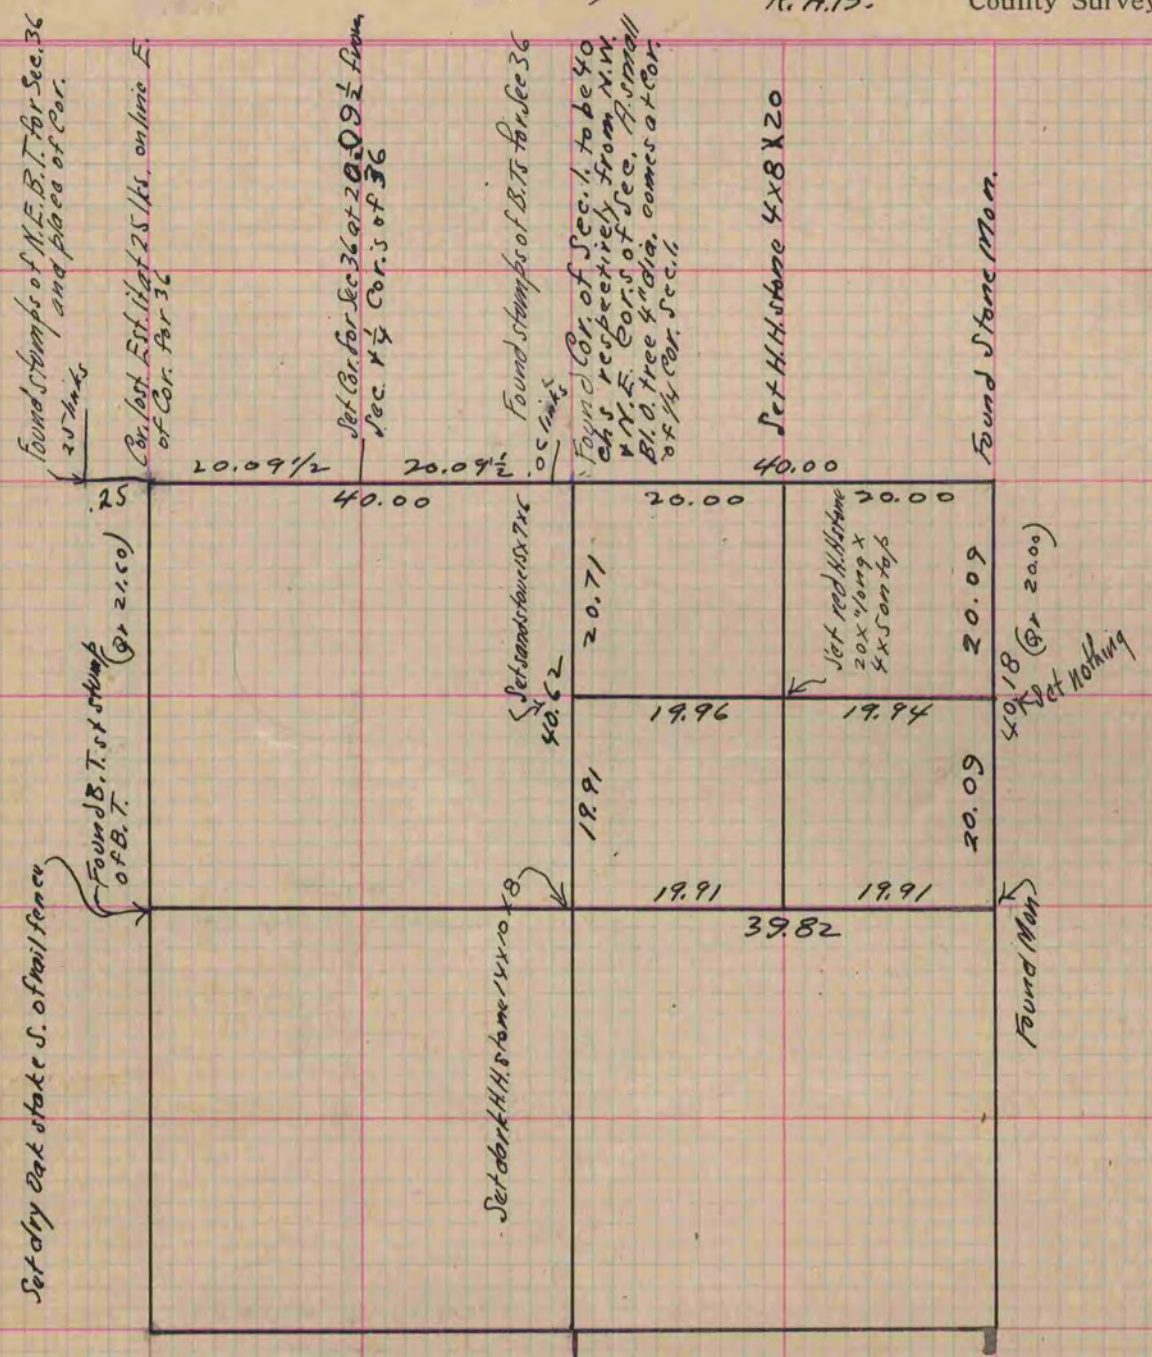

Edgar Hatch & self chainmen

Copied from Page 251 Vol. 2 County Surveyors Record.