PLAT AND RECORD

175
V-14

COUNTY BUILDING
CITY OF JANESVILLE

Of a Survey on Section 16 T 1 R 12 E. of the 4 P. M. in BELOIT Township

Rock County, Wisconsin, made OCT. the 12 th. 1962

I hereby certify that the following is a correct record of said survey as made by me.

R H Batterman
County Surveyor.
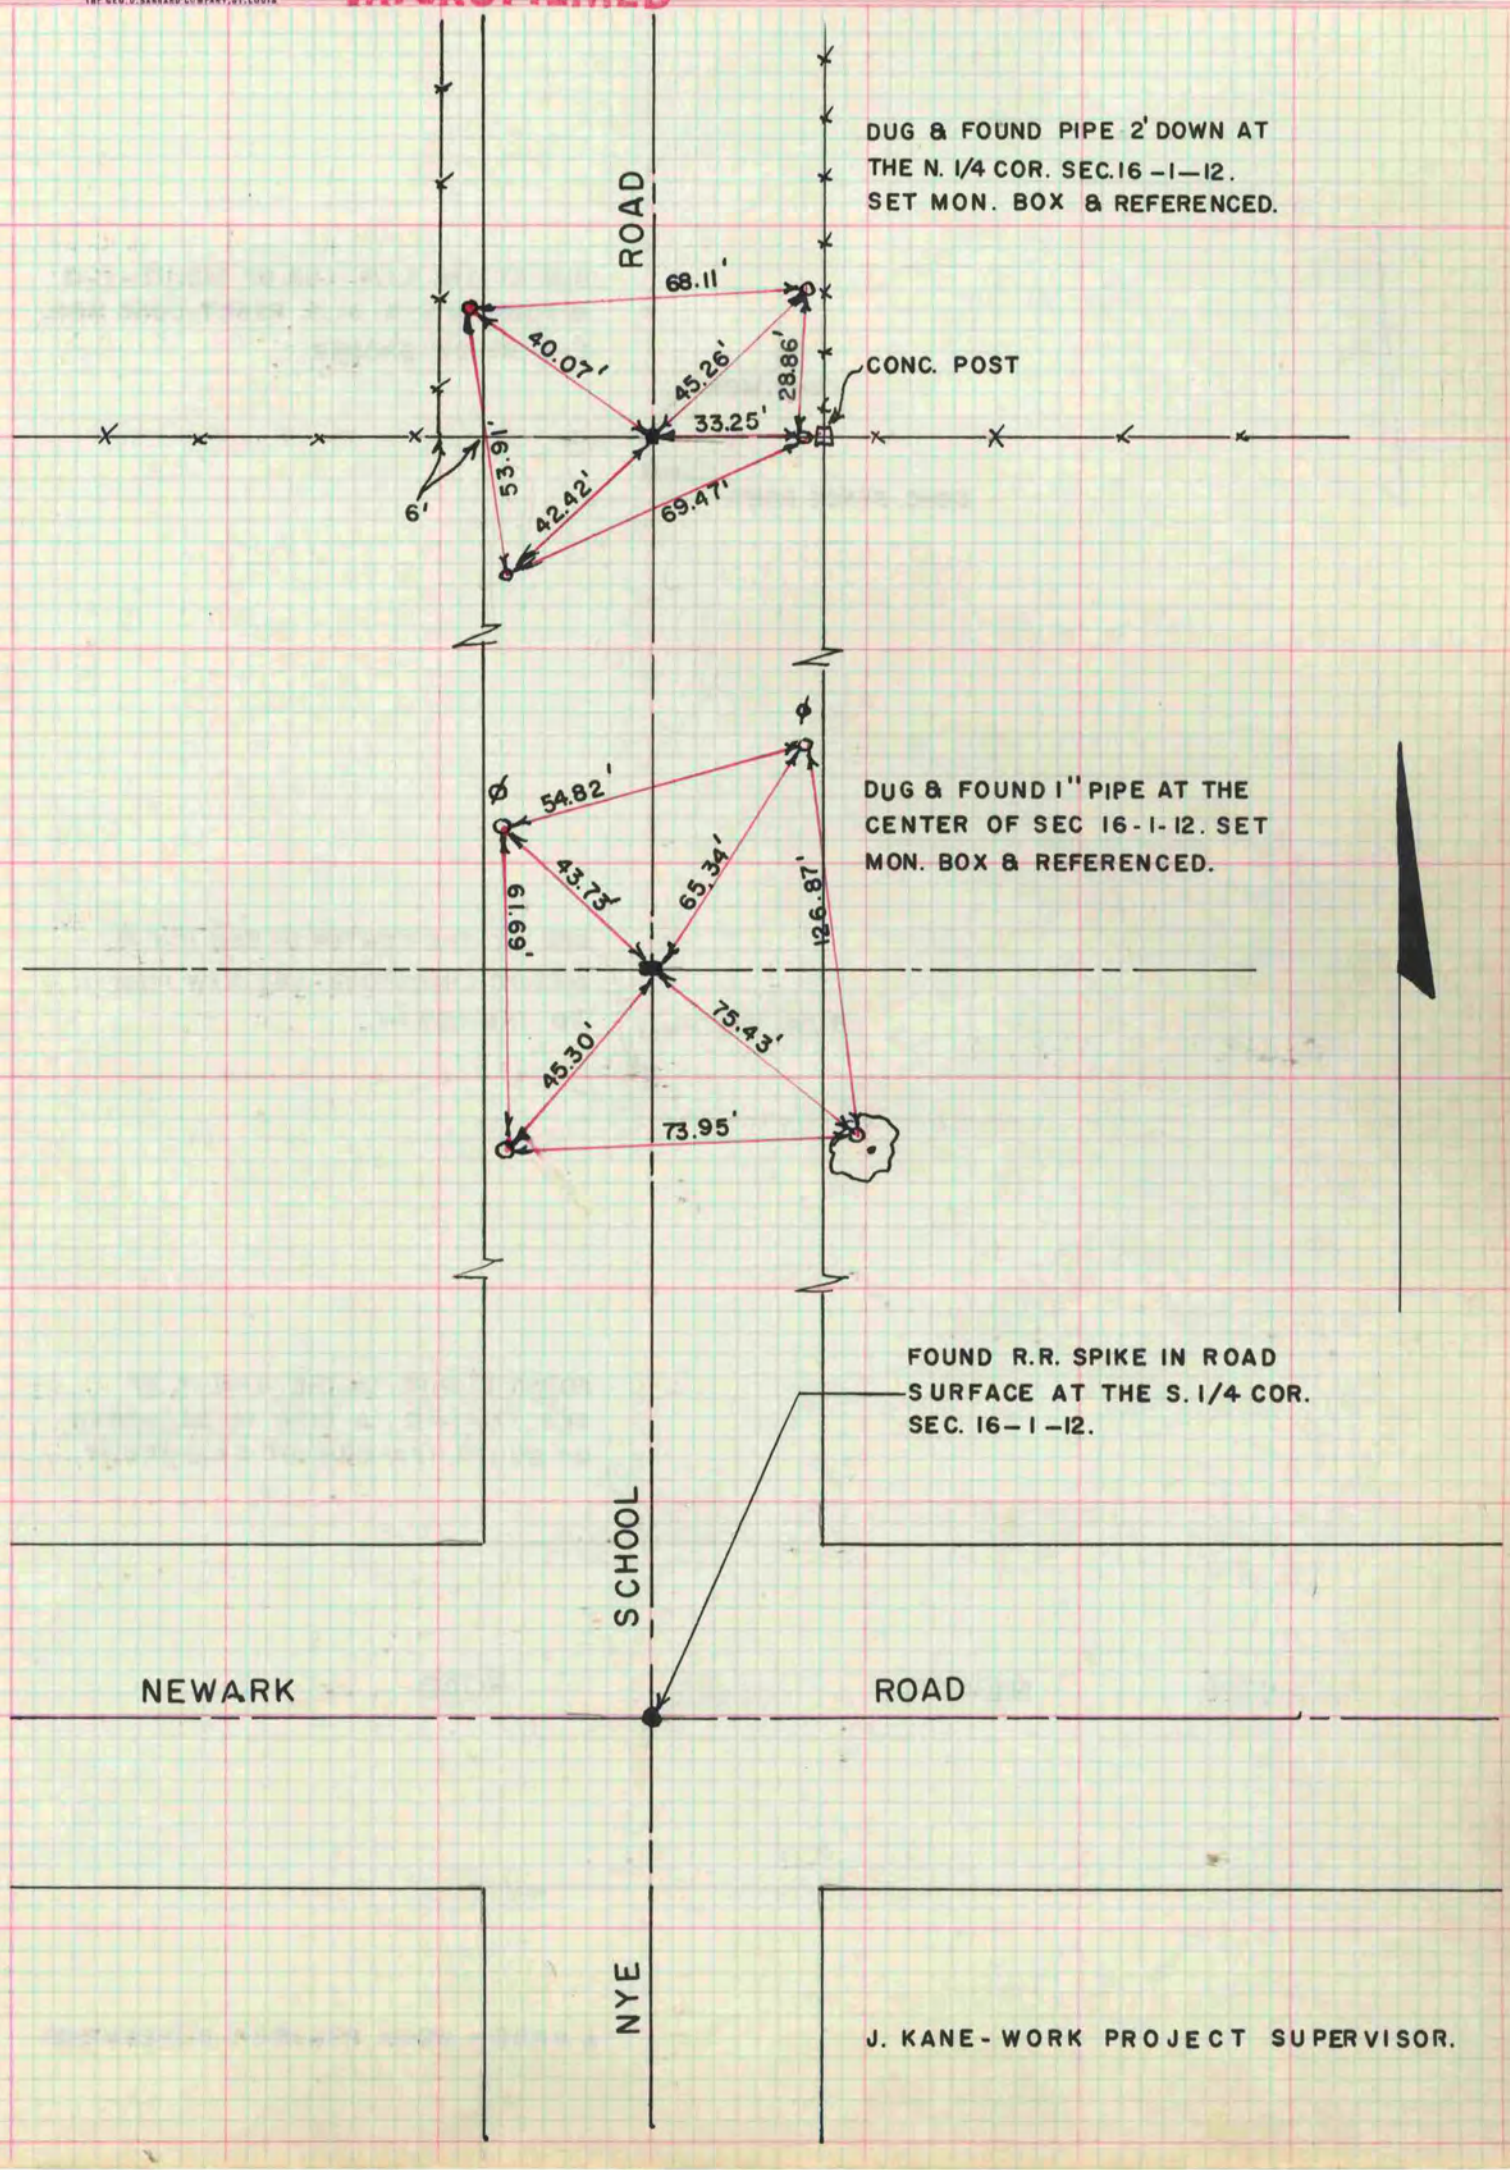
MICROFILMED
THE GEO. D. BARNARD COMPANY, ST. LOUIS