MICROFILMED

PLAT AND RECORD

COUNTY BUILDING
CITY OF JANESVILLE

Of a Survey on Section 4 T 4 R 11 E. of the 4 P. M. in Porter Township

Rock County, Wisconsin, made March the 28-30 & 31 1874

I hereby certify that the following is a correct record of said survey as made by me.

(Signed) Edward Ruger County Surveyor.
R. H. B.

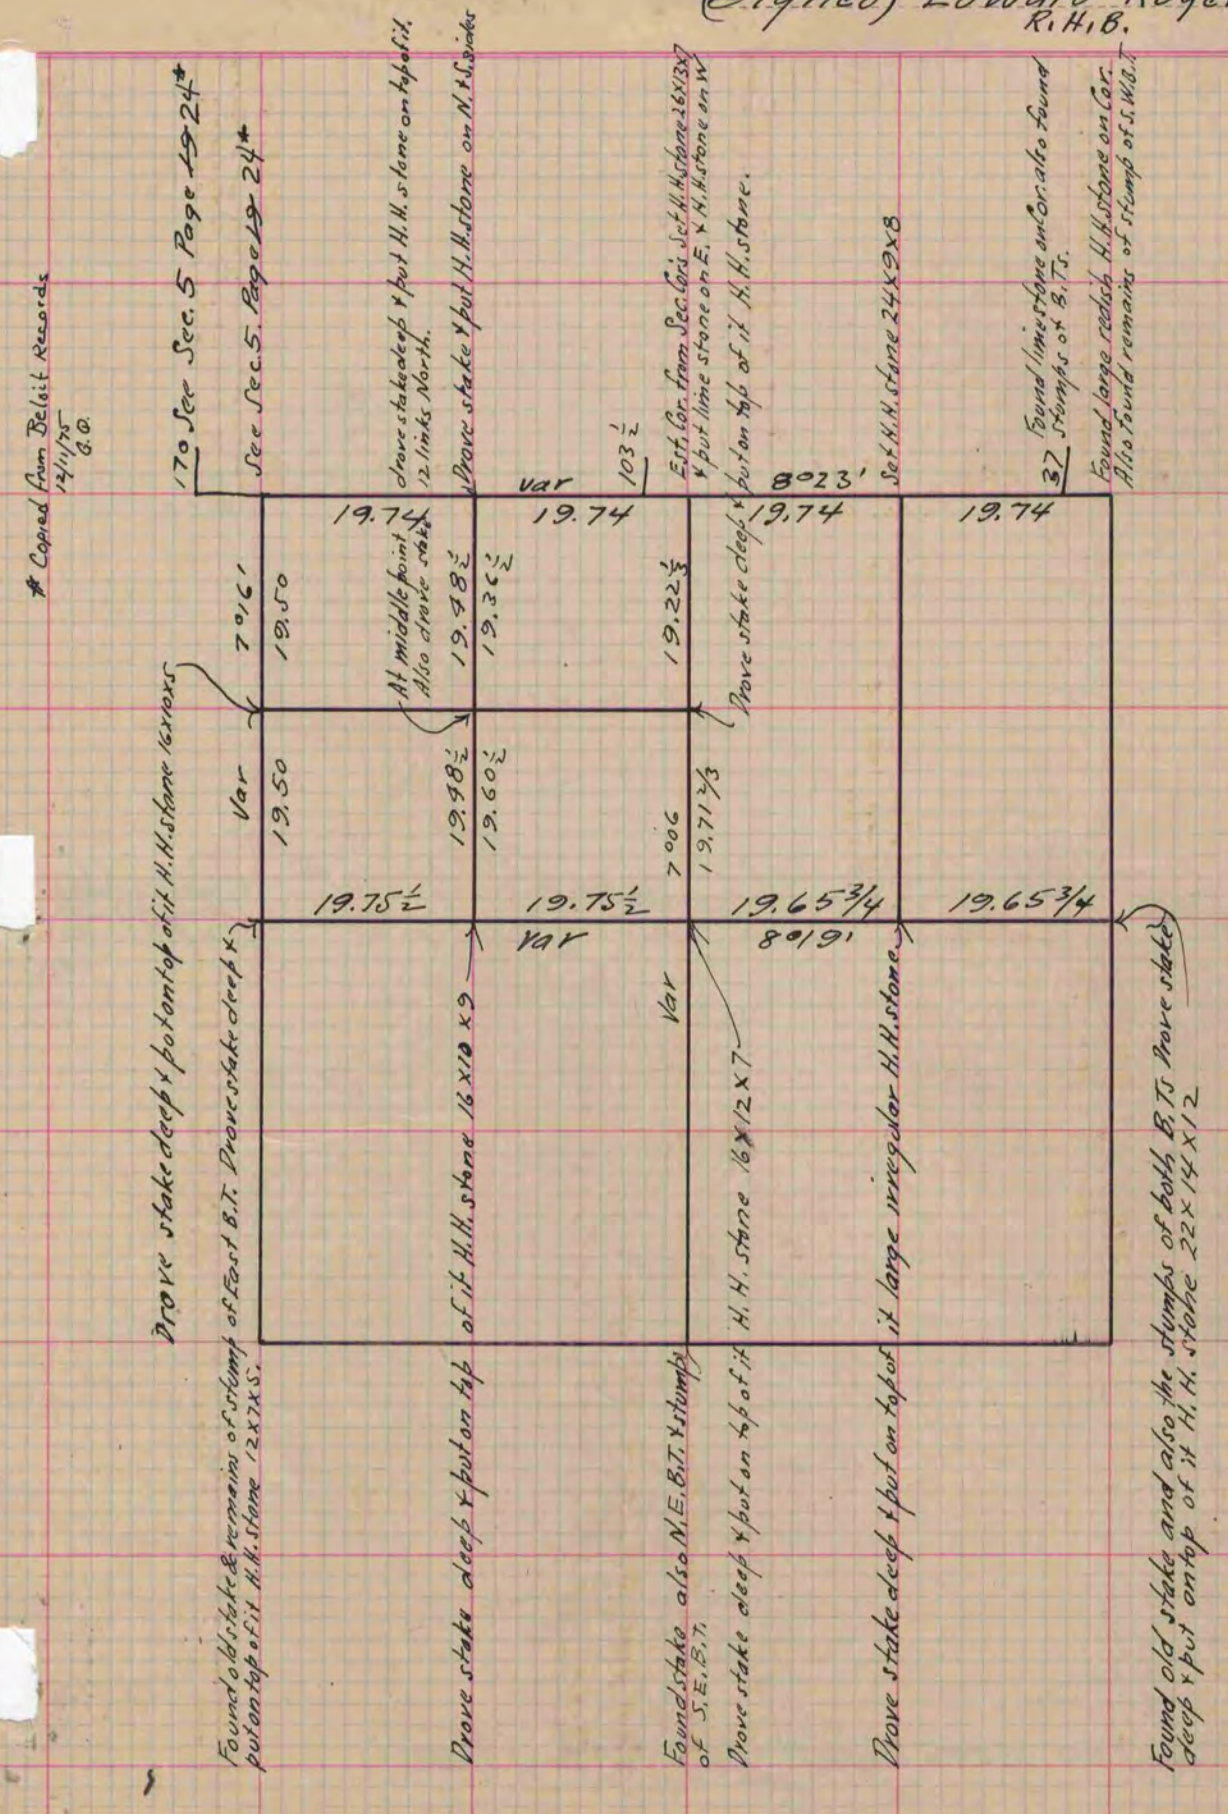

Copied from Page 87 Vol. 2 Original County Surveyors Record.