MICROFILMED
COUNTY BUILDING
CITY OF JANESVILLE

PLAT AND RECORD

Of a Survey on Section 8 T 3 R 10 E. of the 4 P. M. in Magnolia Township

Rock County, Wisconsin, made May the 28th & 30th 1870

I hereby certify that the following is a correct record of said survey as made by me.

(Signed) Edward Roger/ Deputy
R.H.B. County Surveyor.

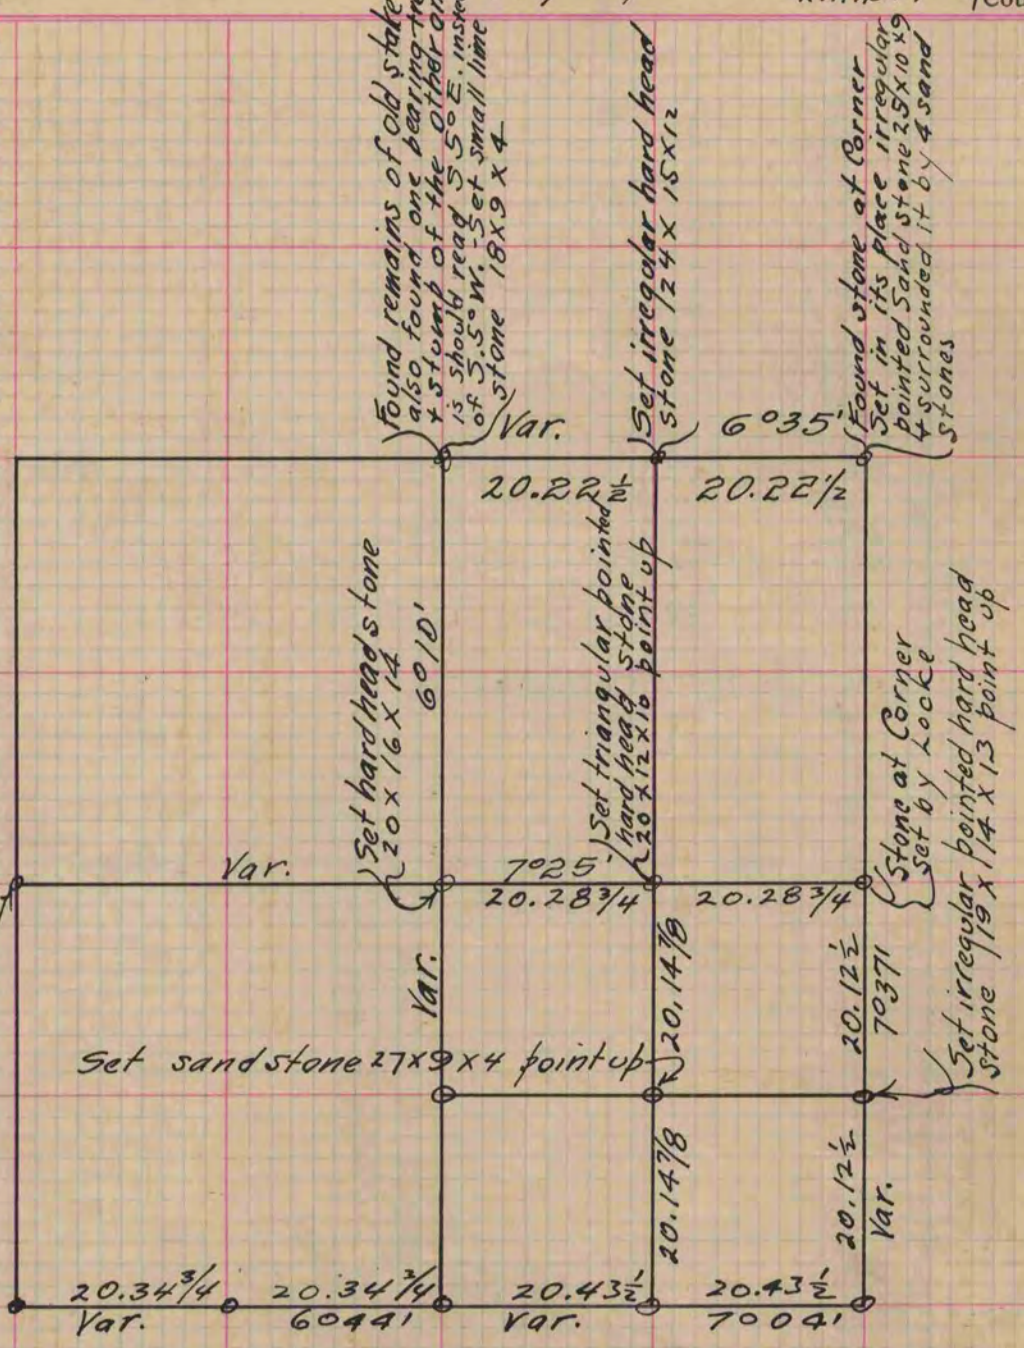

See Section 17 above for corners of South side of this Section (Page 28 this book).
R.H.B.

Copied from lower 1/2 of Page 21 Vol. 2 Original County Surveyors Record.