93
V-2

MICROFILMED

PLAT AND RECORD

Of a Survey on Section 22 T 4 R 14 E. of the 4 P. M. in Lima Township

Rock County, Wisconsin, made April the 23rd & 24th 1872

I hereby certify that the following is a correct record of said survey as made by me.

COUNTY BUILDING
CITY OF JANESVILLE

(Signed) R. K. Lee
R.H.B.
{Deputy County Surveyor.

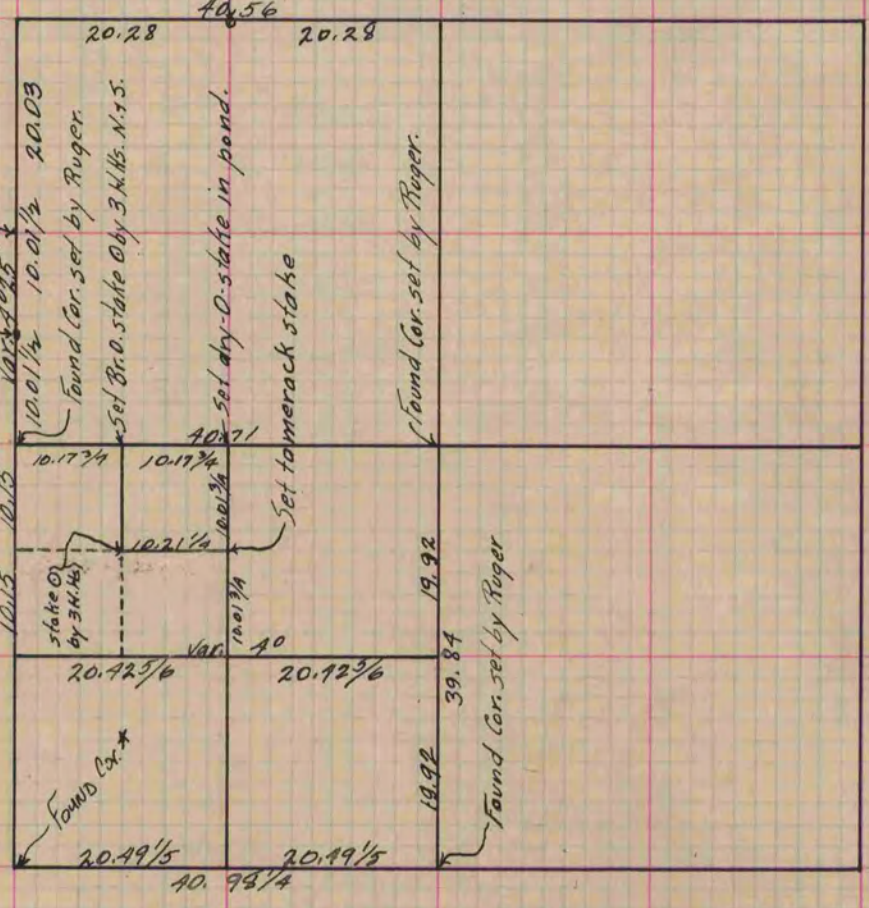

* Copied from Beloit Records
12/10/75
G.Q.

Copied from Page 56 Vol. 2. Original County Surveyor's Record.