PLAT AND RECORD

189
V-5

Of a Survey on Section 8, 28 T 4 N R 14 E. of the 4 P. M. in LIMA Township

Rock County, Wisconsin, made JULY the 30 1976

I hereby certify that the following is a correct record of said survey as made by me.

Donald Barnes County Surveyor.

COUNTY BUILDING
CITY OF JANESVILLE
MICROFILMED

WISCONSIN
DONALD A. BARNES
S-1216
JANESVILLE
WI.
LAND SURVEYOR

E ¼ COR. SEC. 8

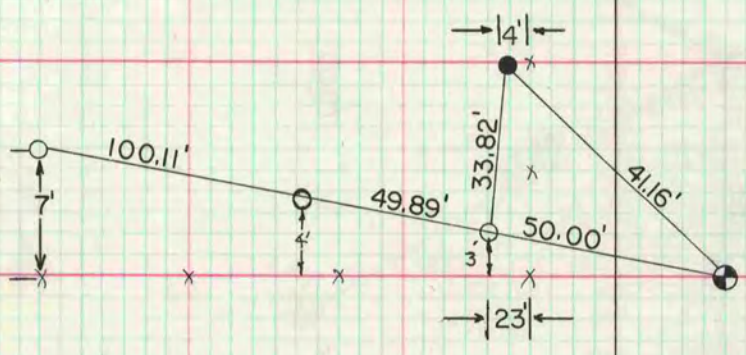

E 1/4 Sec 8
found pin

○ 1 1/2" x 24" pipe with cap
● = 1½" x 24" I.P

C.T.H.
"K K"

W ¼ COR. SEC. 28

Dug and found pin in horizontal position. Reset by using ⅛ cor. and NW cor. Sec. 28.

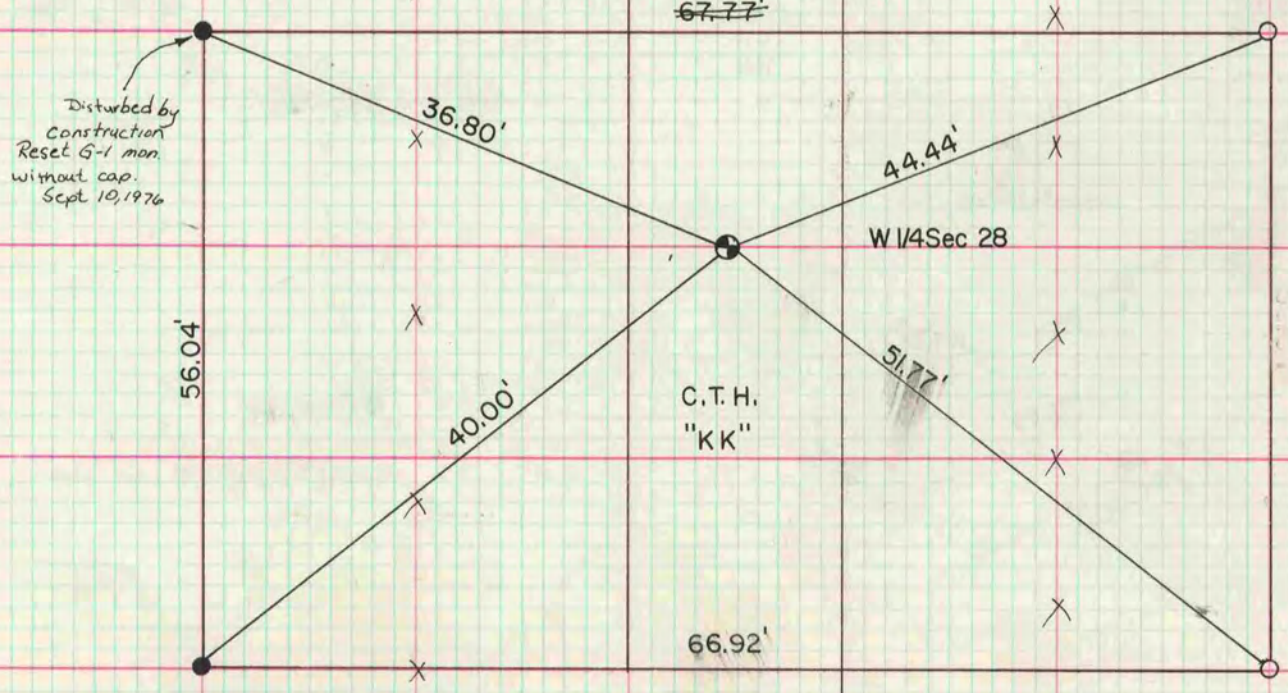

● GI Piston mon with cap
○ 1½ x 24 I P