MICROFILMED
COUNTY BUILDING
CITY OF JANESVILLE



# PLAT AND RECORD

Of a Survey on Sections 4 & 9 T 3 R 10 E. of the 4 P. M. in Magnolia Township

Rock County, Wisconsin, made June the 1st & 2nd 1887

I hereby certify that the following is a correct record of said survey as made by me.

(Signed) R. K. Lee
R.H.B. Dep. County Surveyor.

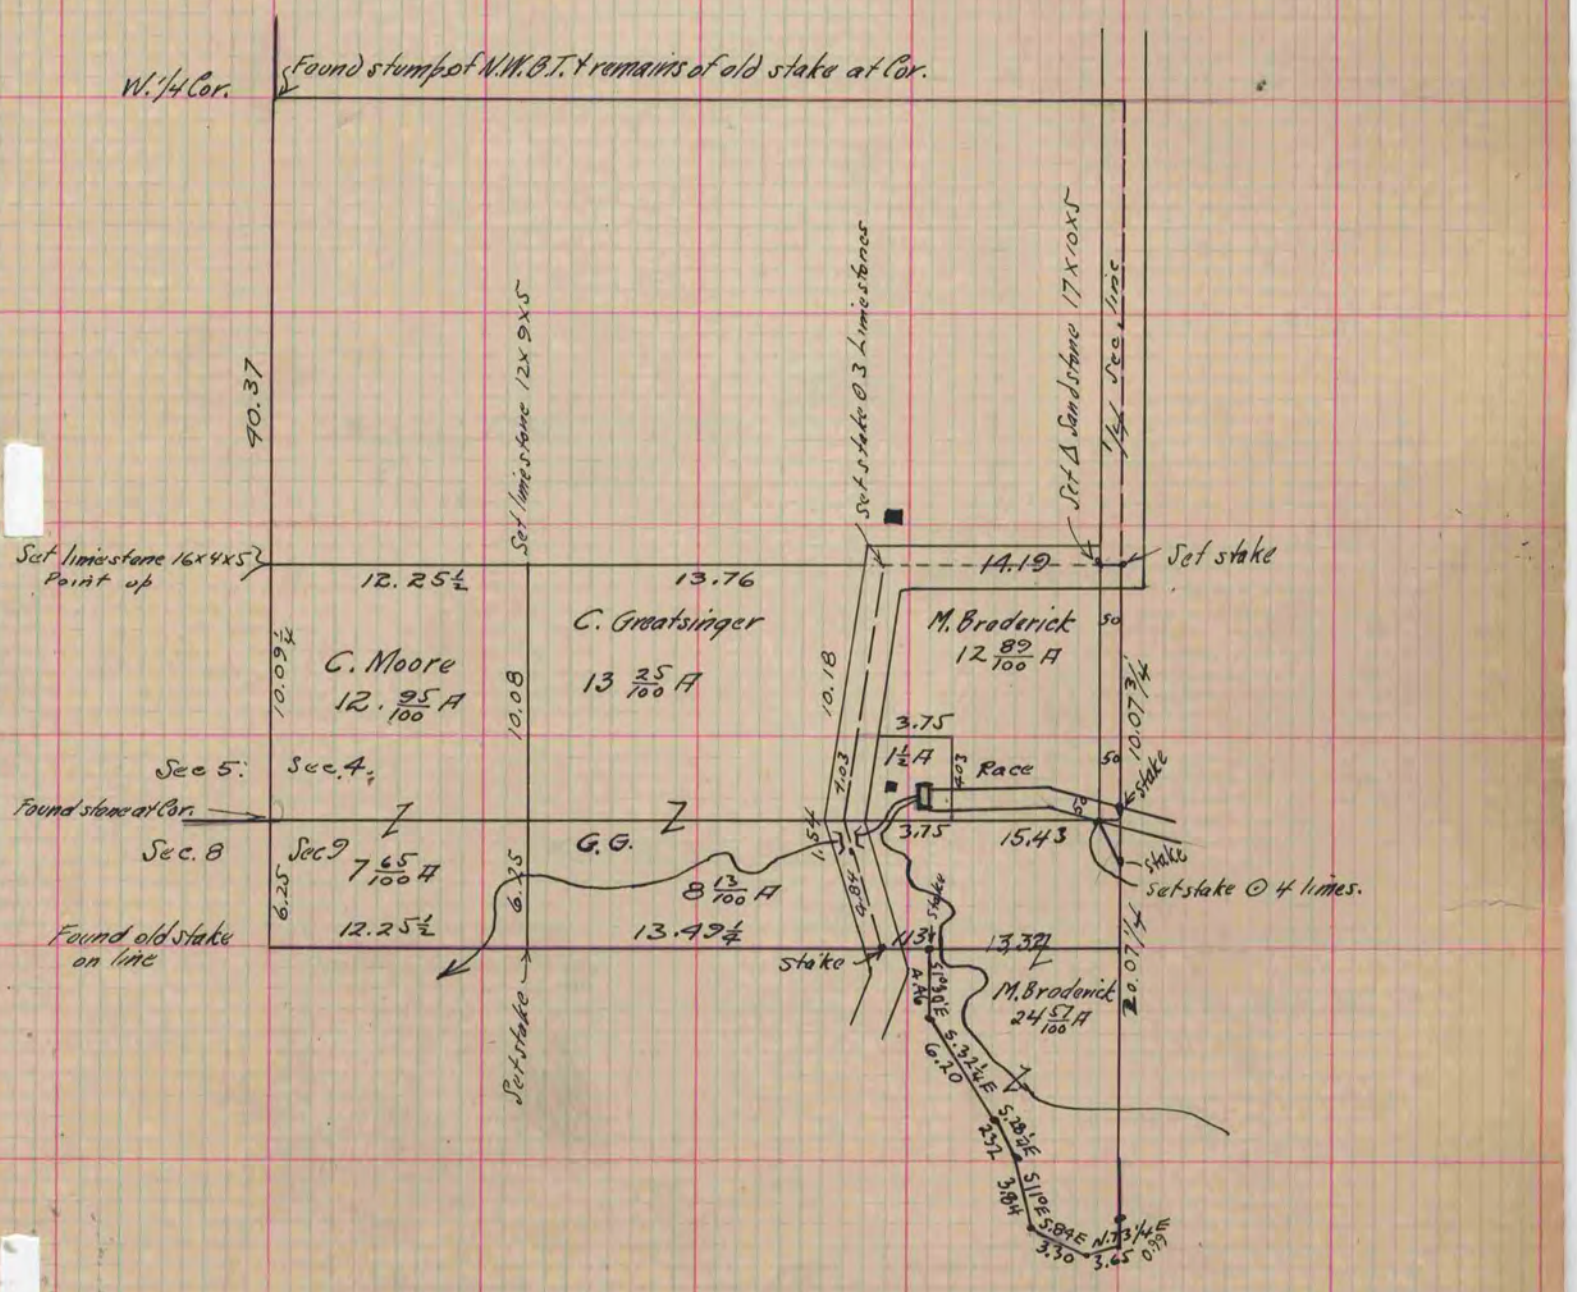


Copied from P. 315 Vol. 2. County Surveyors Record.