MICROFILMED

PLAT AND RECORD

29
V-3

Of a Survey on Section 5 T 1 R 14 E. of the 4 P. M. in Clinton Township

Rock County, Wisconsin, made November the 1905

I hereby certify that the following is a correct record of said survey as made by me.

COUNTY BUILDING
CITY OF JANESVILLE
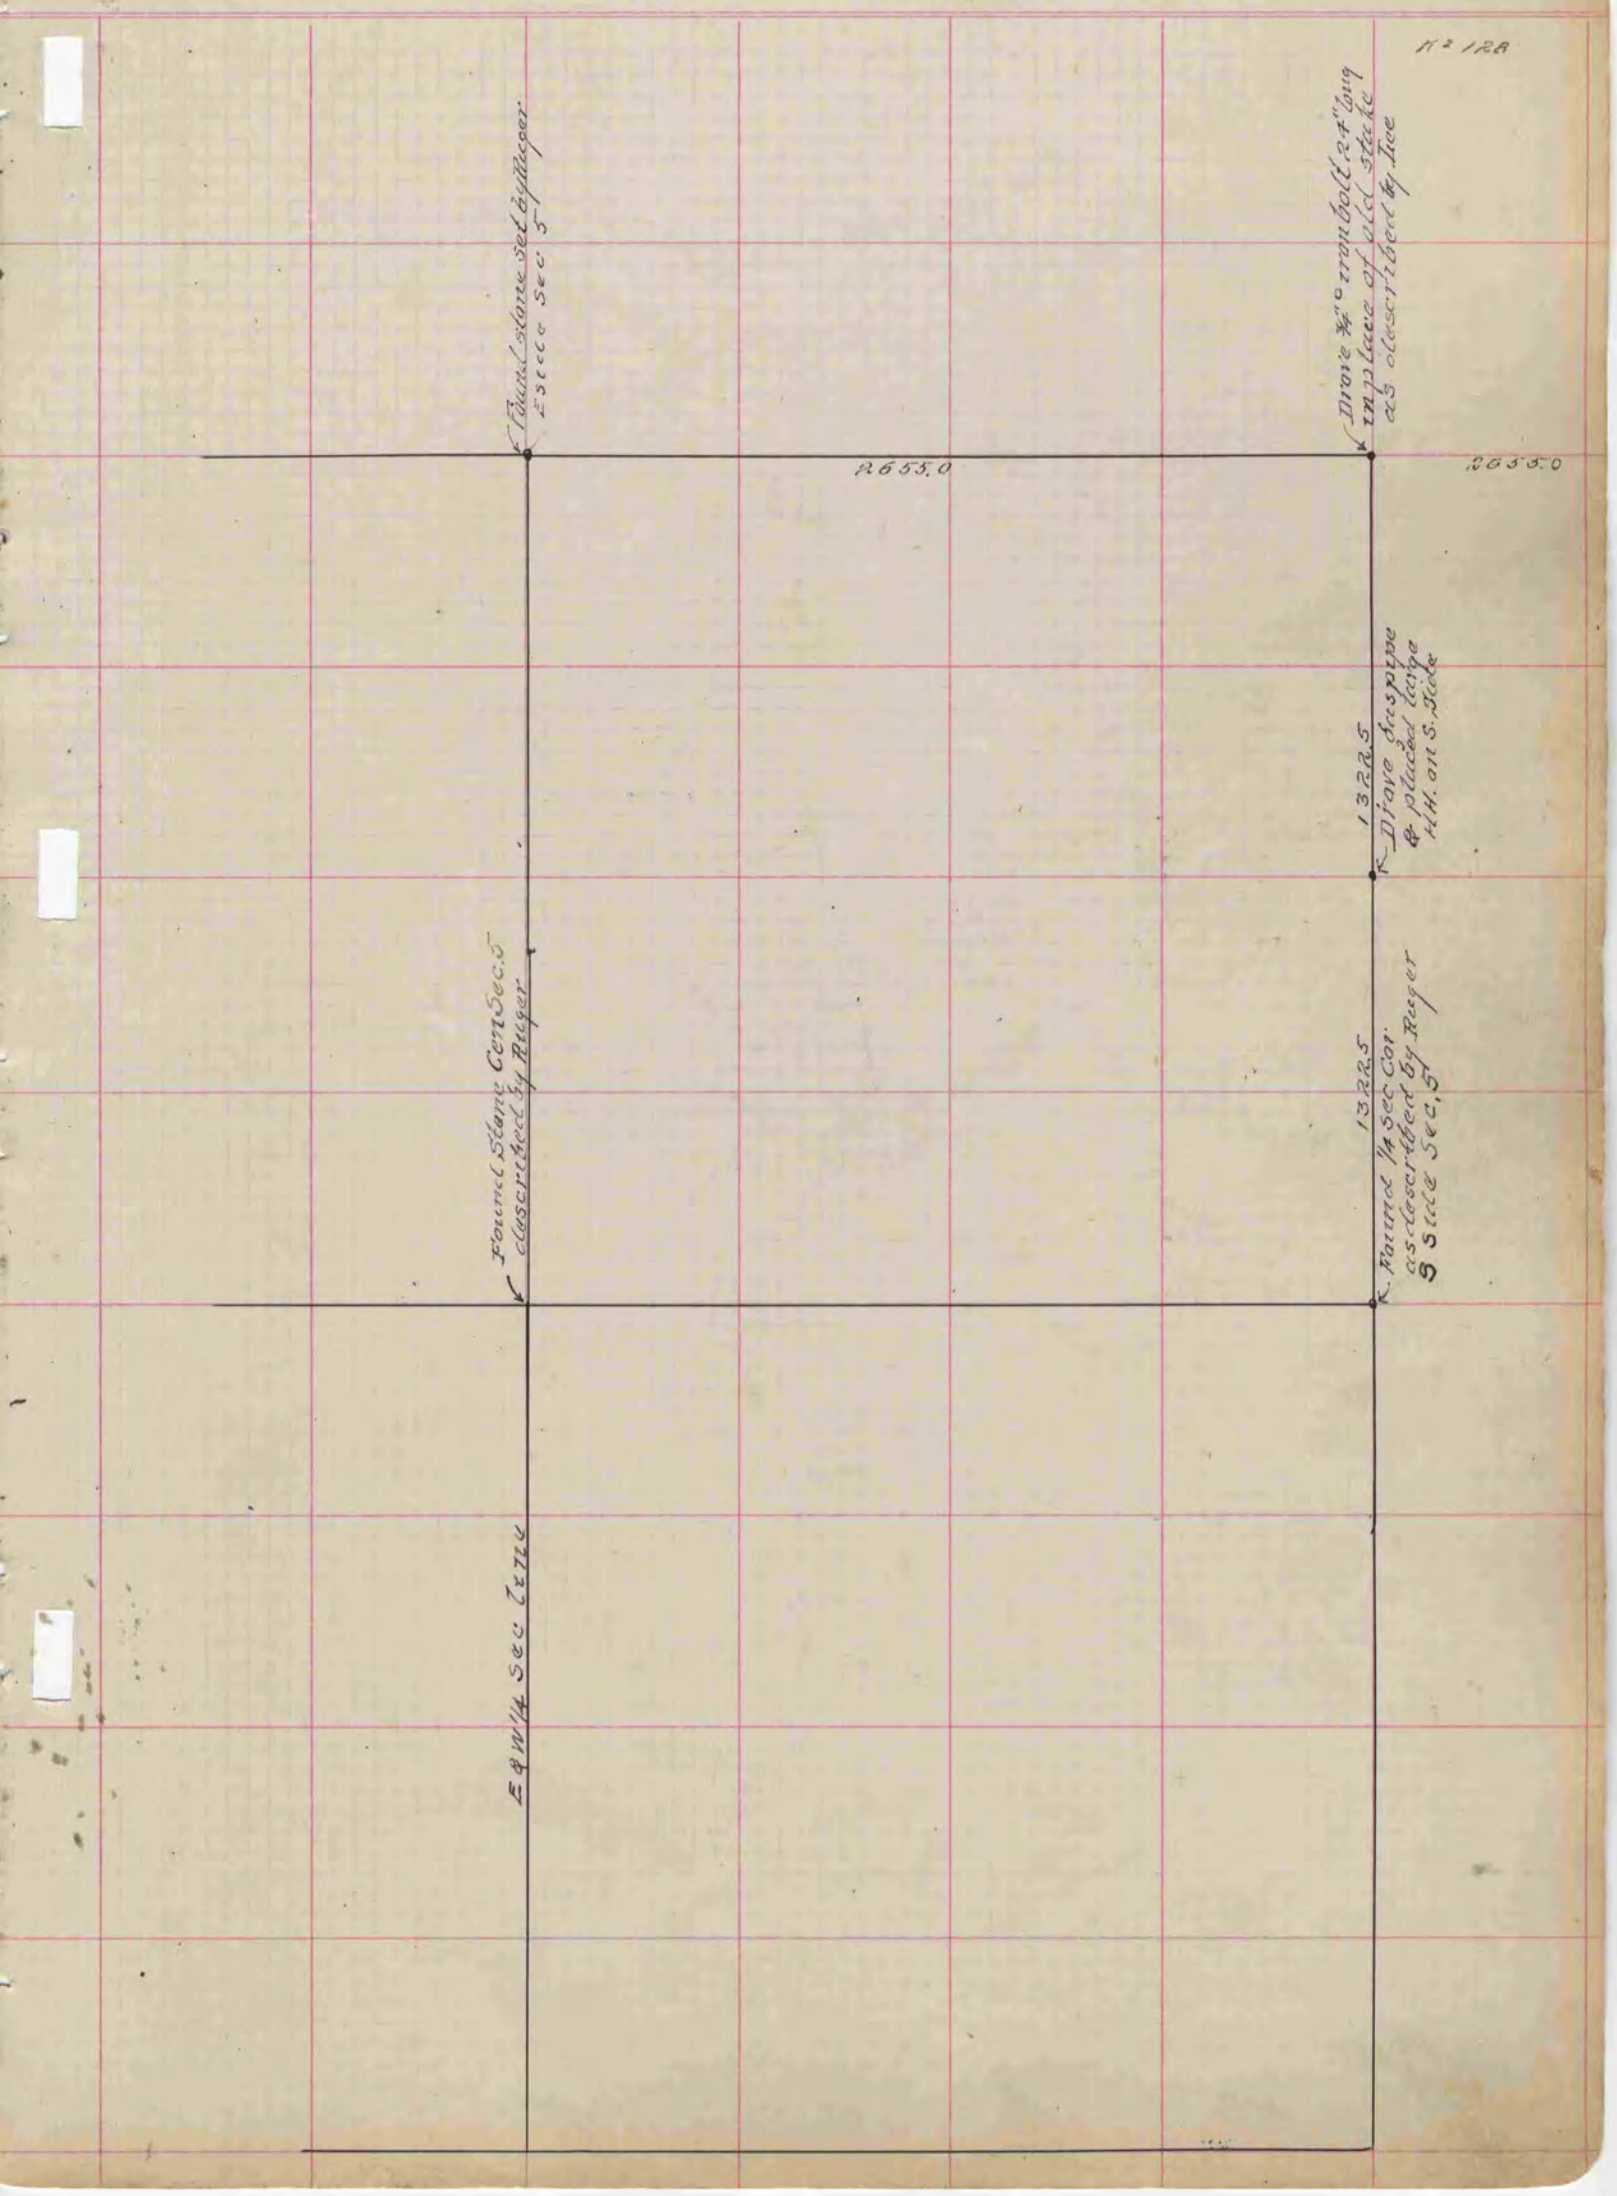
C V Tierch
County Surveyor.