551
V-3

PLAT AND RECORD

COUNTY BUILDING
CITY OF JANESVILLE

Of a Survey on Section 3-4 T 1 R 12 E. of the 4 P. M. in BELOIT Township

Rock County, Wisconsin, made _____ the _____ 19

I hereby certify that the following is a correct record of said survey as made by me.

MICROFILMED
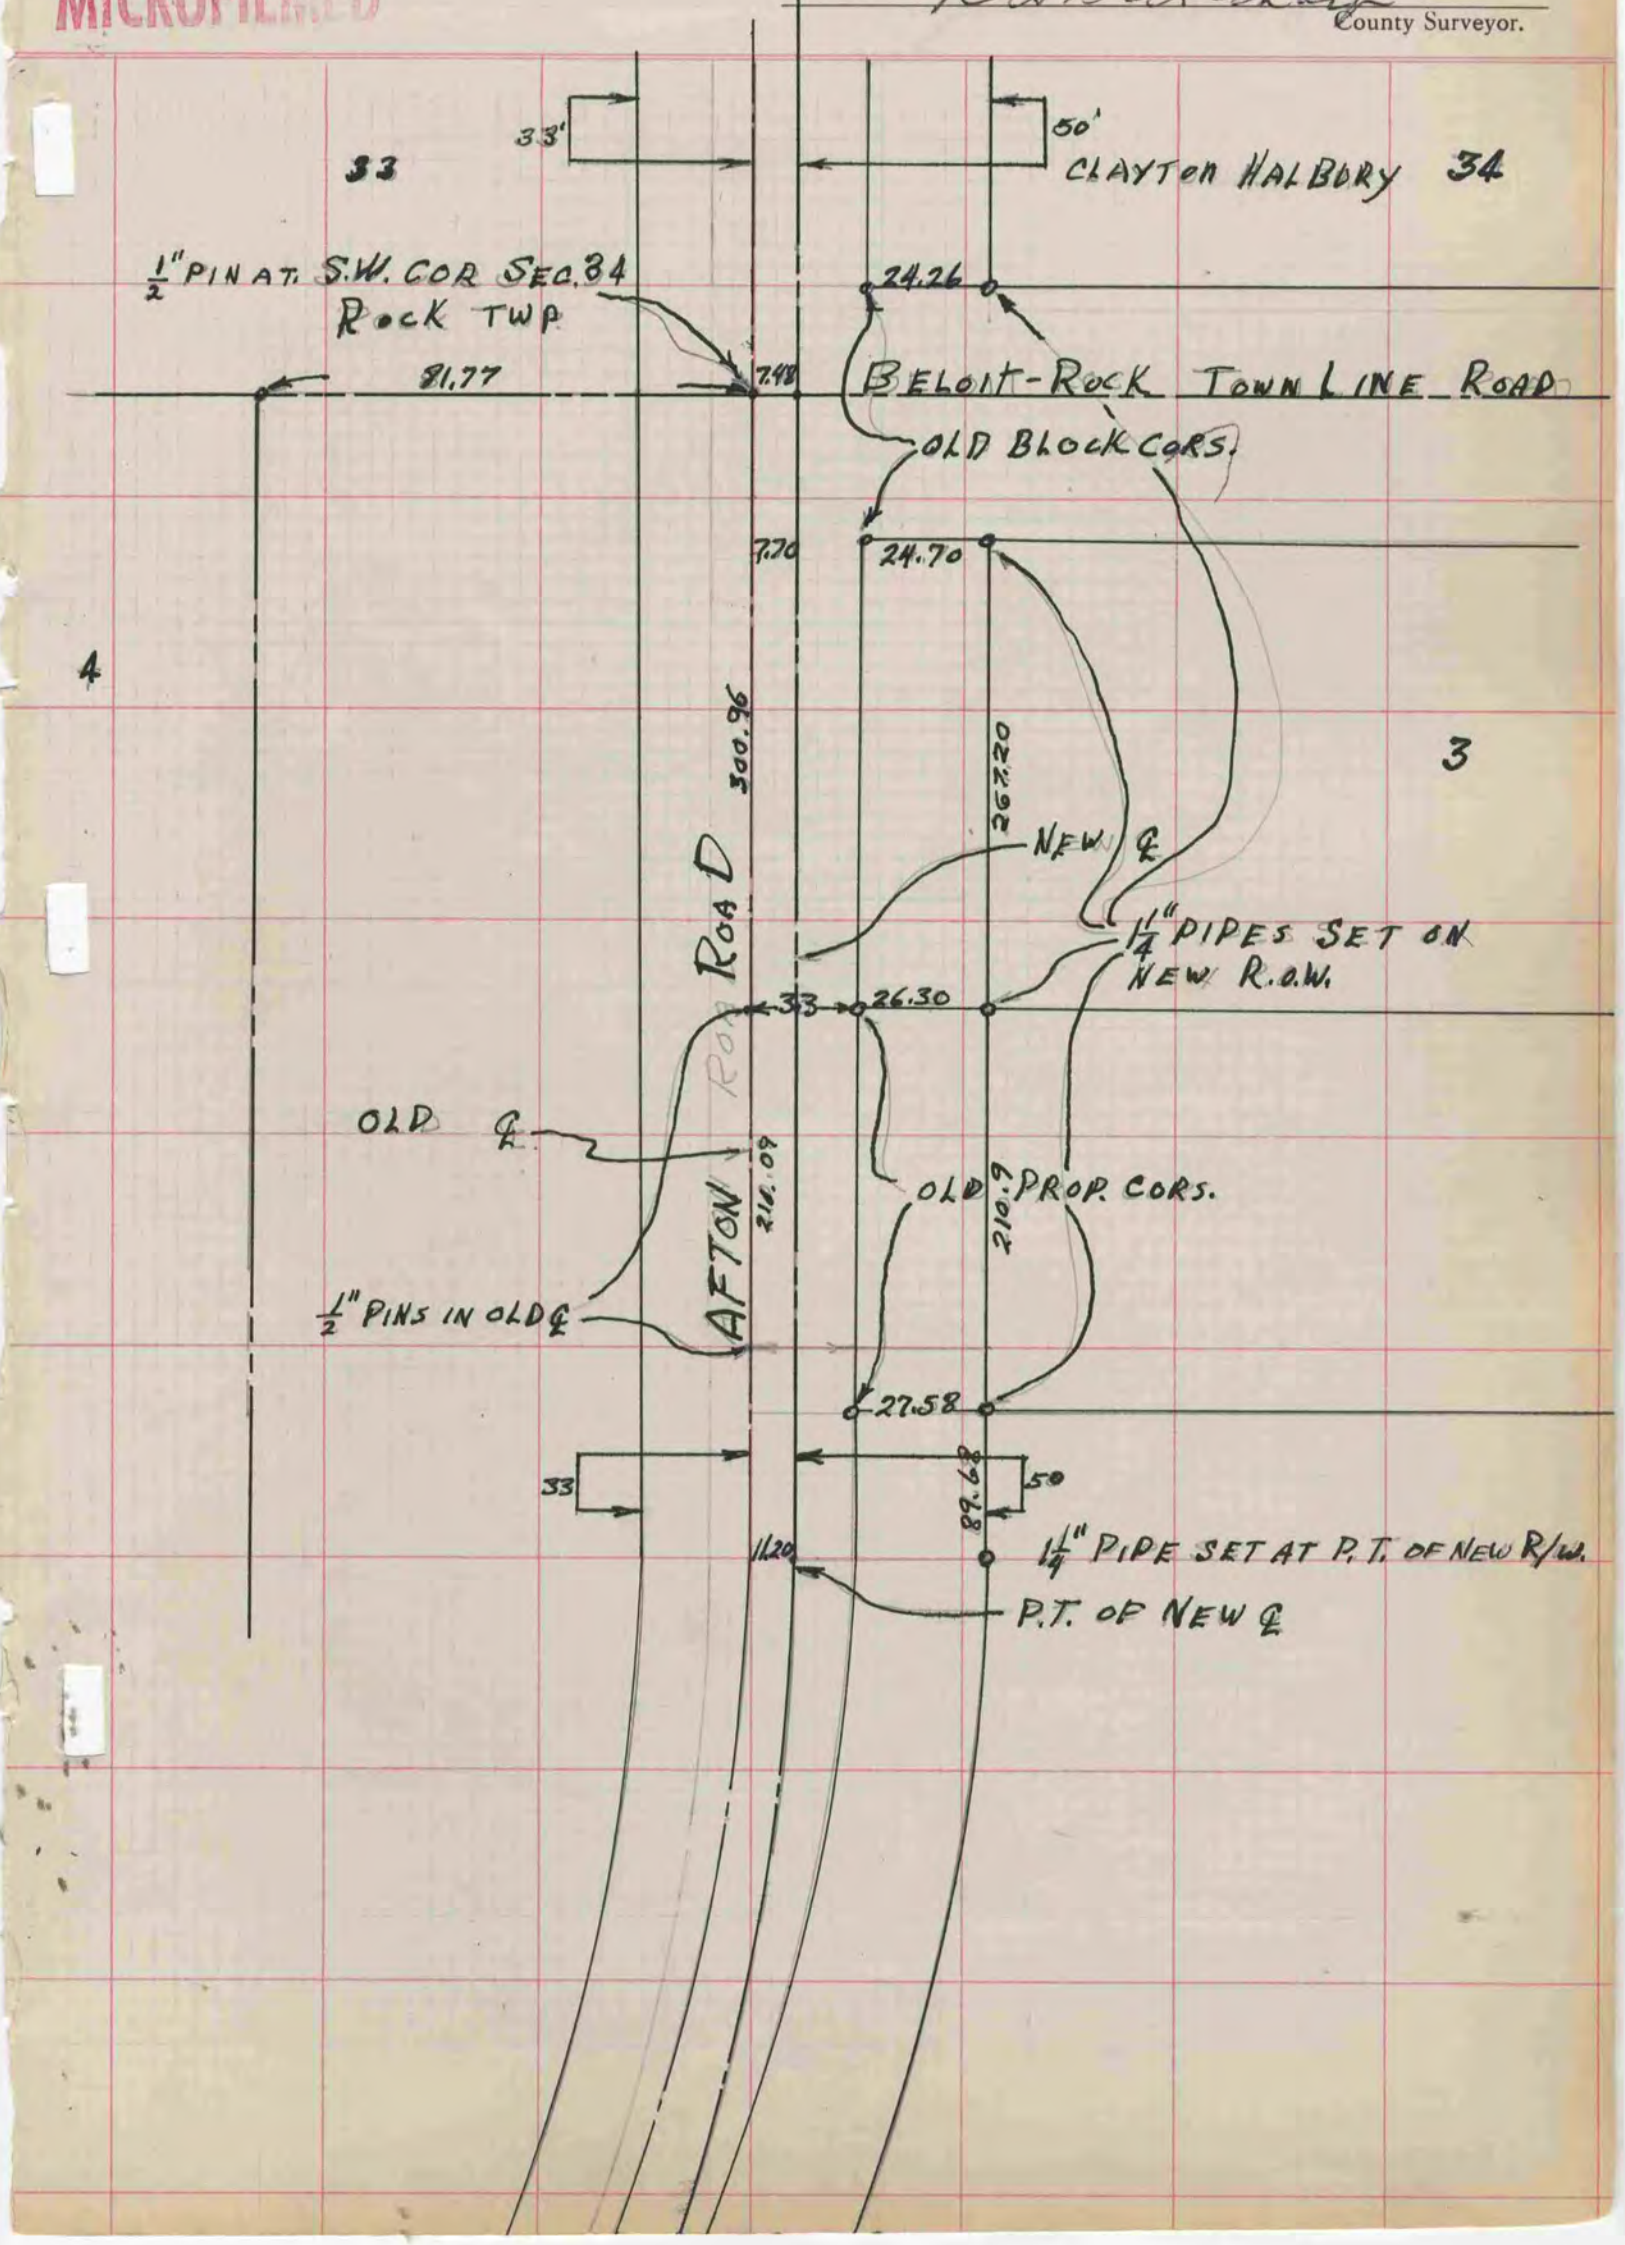
R. A. Batterman
County Surveyor.