MICROFILMED

PLAT AND RECORD

Of a Survey on Section 33 T 1 R 10 E. of the 4 P. M. in Avon Township

Rock County, Wisconsin, made August the 19+20 1873

I hereby certify that the following is a correct record of said survey as made by me.

COUNTY BUILDING
CITY OF JANESVILLE

(Signed) Edward Ruger
R.H.B. County Surveyor.

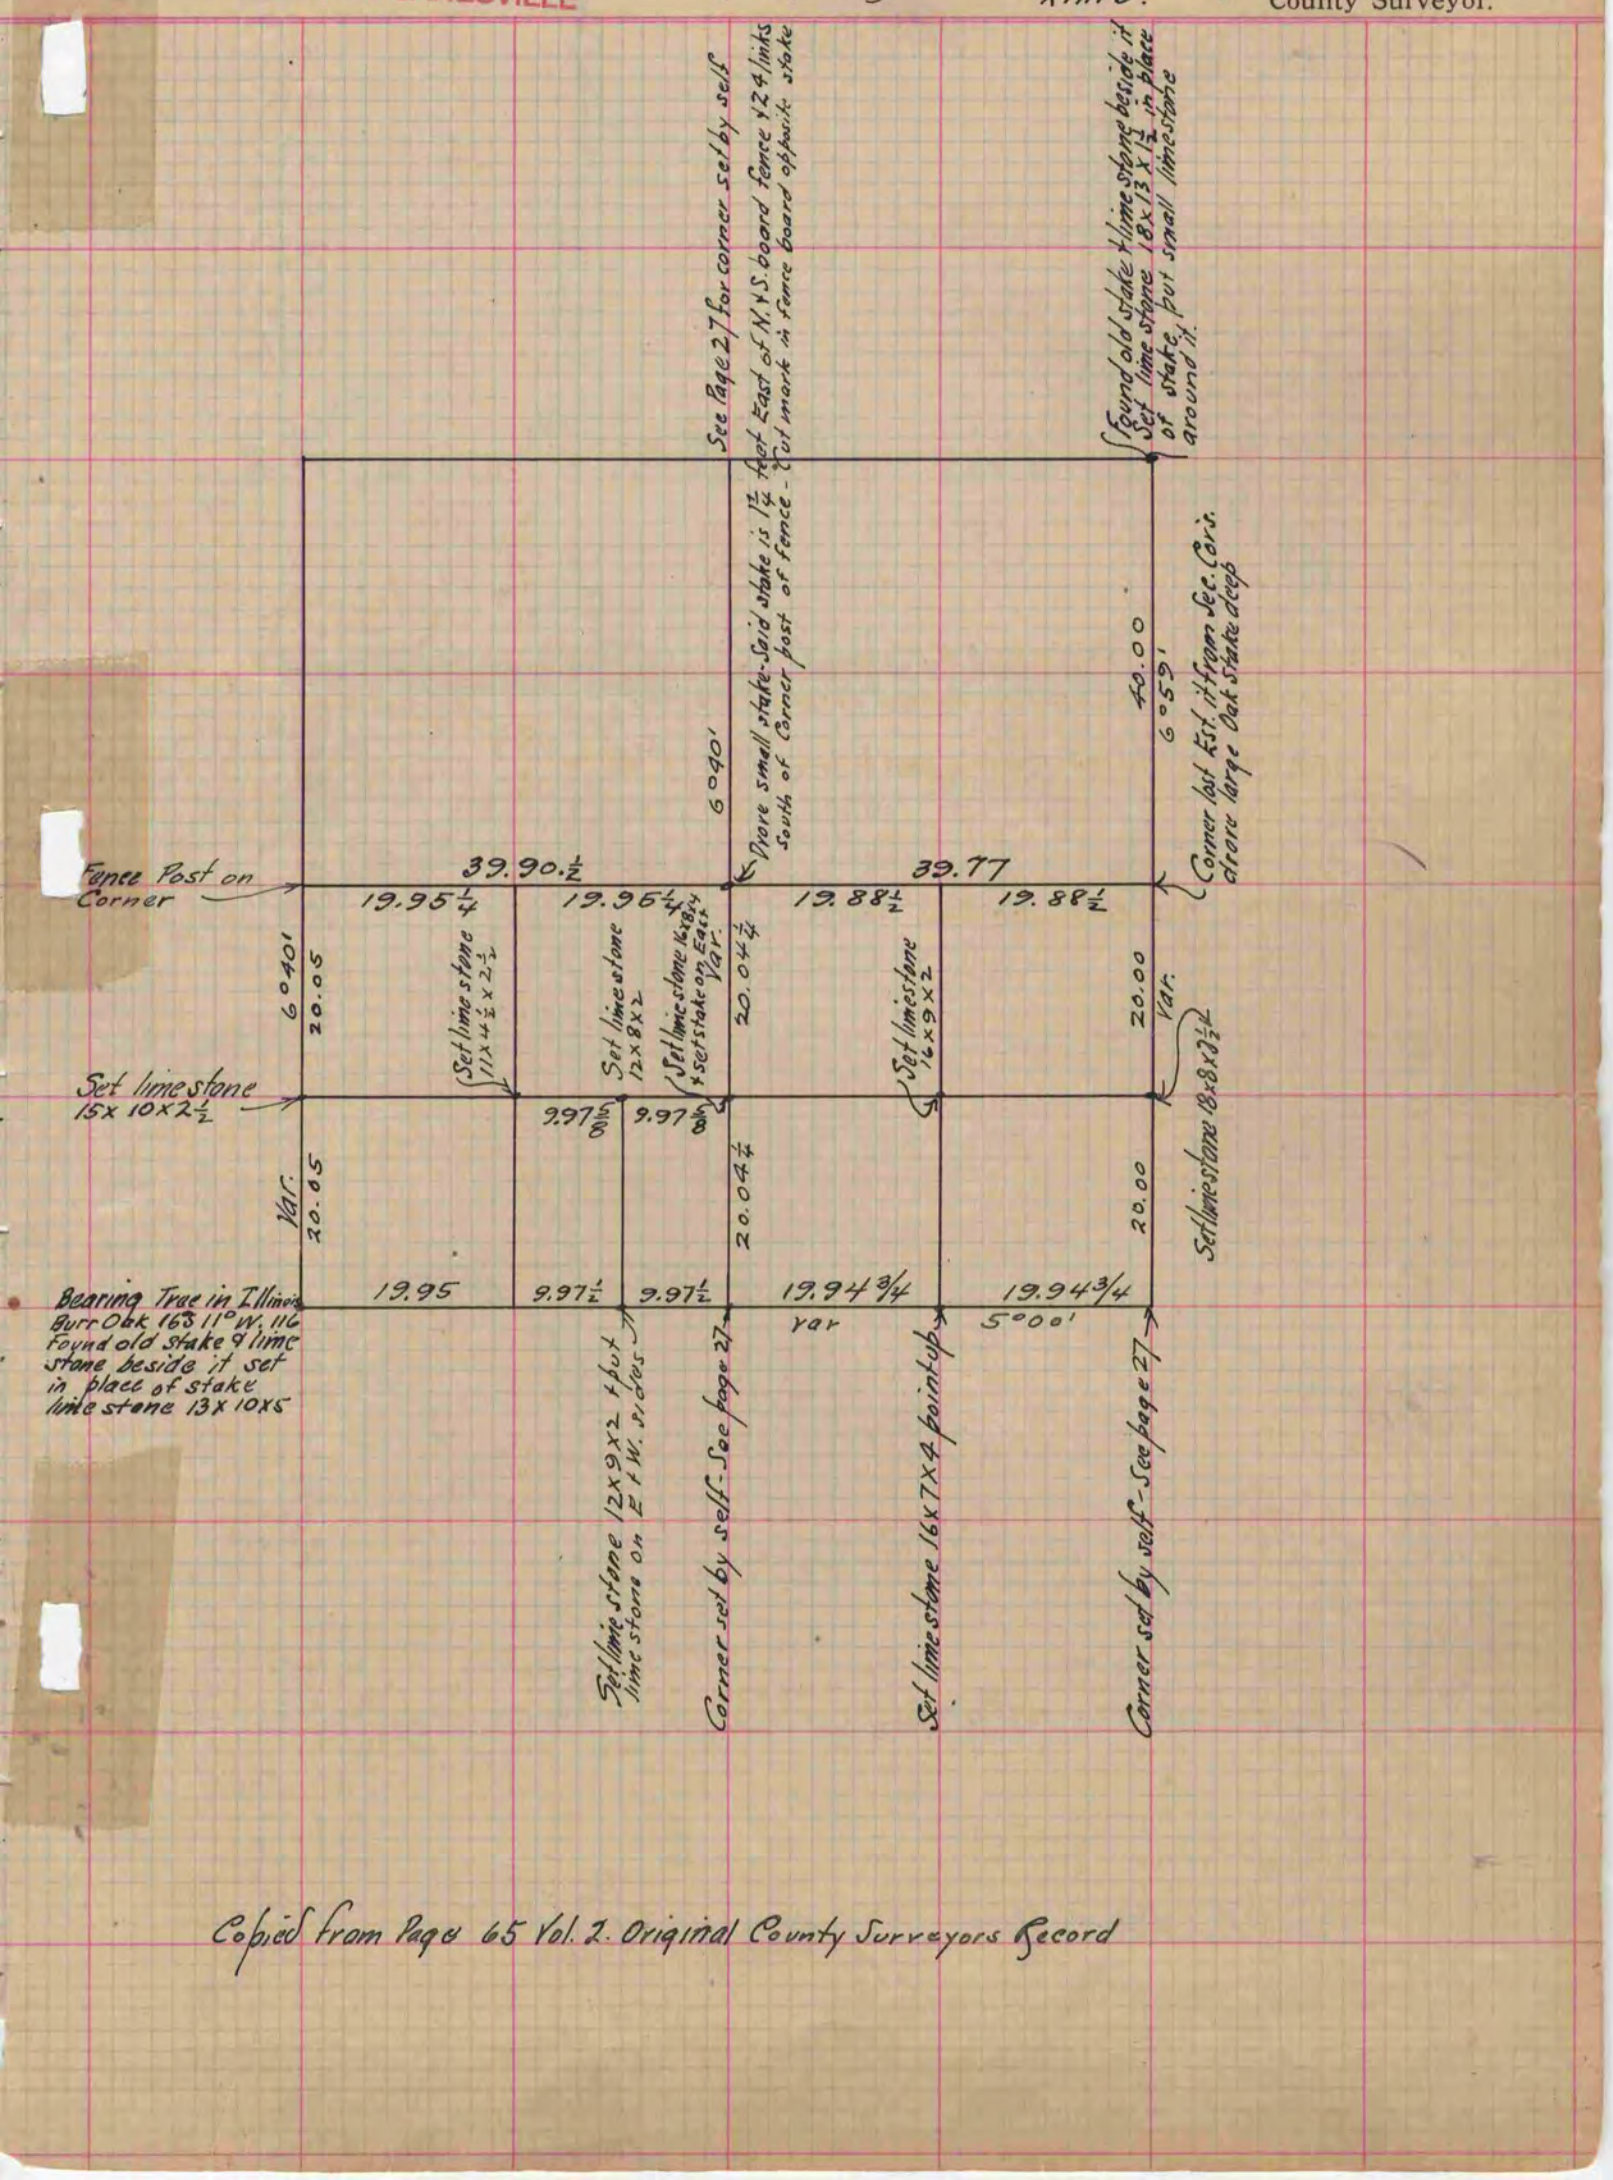

Copied from Page 65 Vol. 2. Original County Surveyors Record